

**Chemung County Stormwater  
Construction Inspection  
Erosion and Sediment Control**

Project Name: <u>Parmenter Tire</u>	Date: <u>11/12/2013</u>
Location: <u>Holding Point Horseheads (v)</u>	Permit #: <u>NYR10X325</u>
Weather Conditions: <u>clear - cold blustery</u>	Entry Time:
On-Site Representative Present: <u>Bob Young - Village</u>	Exit Time:
Sketch of Project site - Include Disturbed Areas: <u>of horseheads</u>	

Yes	No	N/A	
	X		All erosion and sediment control measures installed/constructed
	X		All erosion and sediment control measures maintained properly
X			Are there currently more than 5 acres disturbed w/o prior approval
	X		Have stabilization measures been initiated in inactive areas
X			Are permanent stormwater control measures being implemented
	X		Was there a discharge into the receiving water on the day of inspection
	X		Evidence of turbidity or oil in the receiving waters
	X		Are weekly inspections being performed?
	X		Are the inspections being performed by a qualified individual?

Comments:

- ① SWPPP Construction Sequence is not being followed.
  - ② 5 acres is disturbed without authorization.
  - ③ Silt fence is in poor condition around the site.
  - ④ Construction Entrance onto 5th Street not installed
  - ⑤ Qualified inspections not being done.
- Bob Young shut the site down for being out of compliance

Satisfactory                       Marginal                       Unsatisfactory

Date: 11/12/2013 Inspector: Jessica Verrigine

with stormwater laws and ~~was~~ doing work on the building before it was approved.

Tyler Griffen doing earth disturbing work  
Contractor



CHEMUNG  
COUNTY  
STORMWATER  
COALITION

851 Chemung Street  
Horseheads, New York 14845  
Ph. 607.796.2216

**PROJECT:** Parmenter Tire  
Village of Horseheads  
November 12, 2013  
Municipal Construction

**BY** Jessica Verrigni, CPESC, CPSWQ



Building location-Building is not sited according to the plan and not set back 100' from 5<sup>th</sup> street as plan shows.



Entire site is open and disturbed without 5 acre written authorization.




Stormwater pond has been graded in.



Silt fence is down or off its posts in many areas around the site.

footers filled in

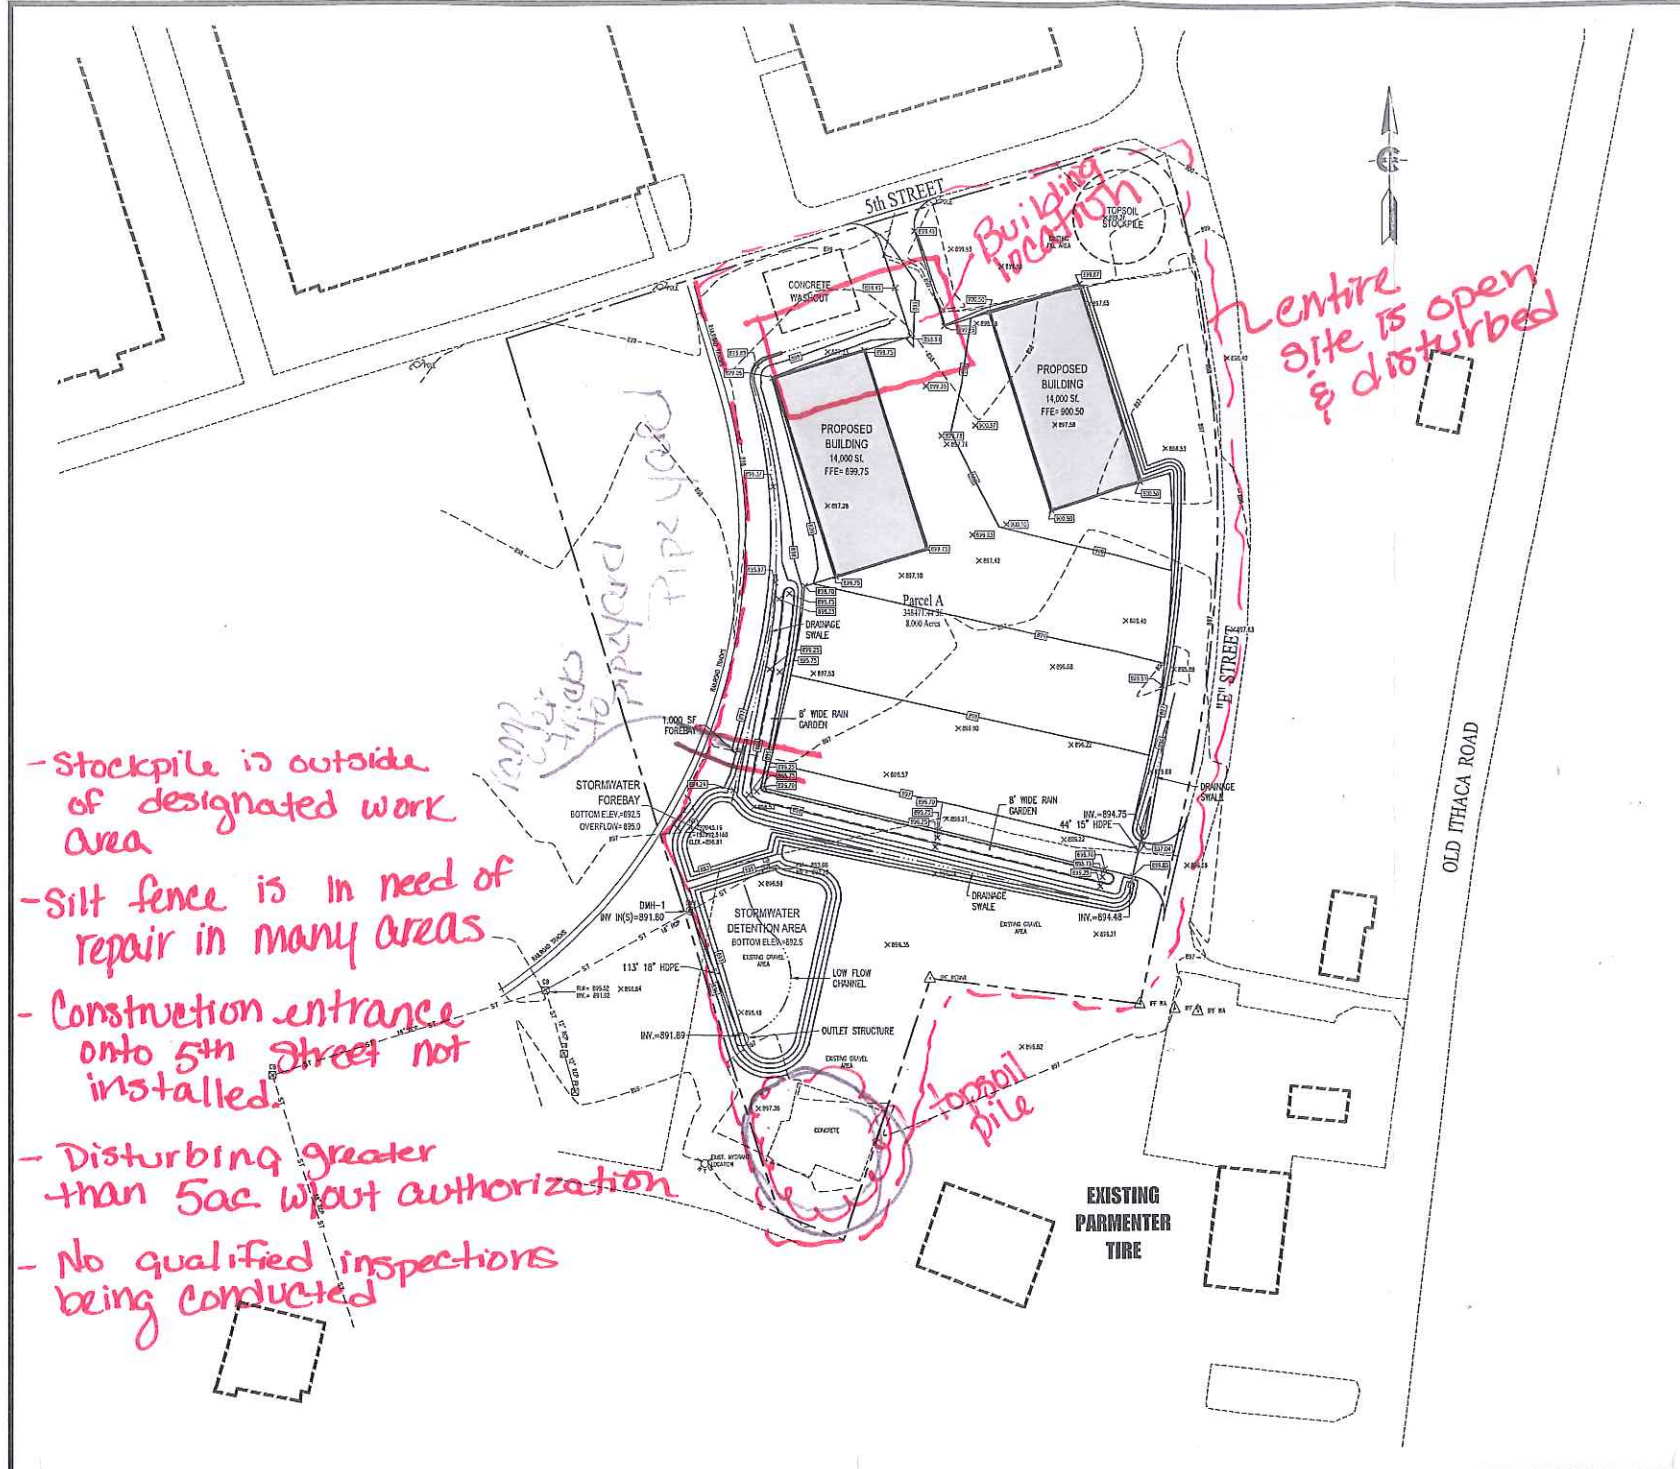

- Stockpile is outside of designated work area
- Silt fence is in need of repair in many areas
- Construction entrance onto 5th Street not installed
- Disturbing greater than 5ac w/out authorization
- No qualified inspections being conducted

**LEGEND**

---	PROPERTY LINE
---	EXISTING EASEMENT
---	EXISTING EDGE OF ROADWAY
---	EXISTING CURB LINE
---	EXISTING SANITARY SEWER
---	EXISTING GAS MAIN
---	EXISTING UTILITY LINE
---	EXISTING FENCE LINE
---	EXISTING WATER LINE
---	EXISTING CONTOUR LINE
---	PROPOSED CONTOUR LINE
---	PROPOSED EASEMENT
---	PROPOSED STORM SEWER
---	PROPOSED EDGE OF ROADWAY
---	PROPOSED CURB LINE
---	PROPOSED SANITARY SEWER
---	PROPOSED GAS LINE
---	PROPOSED UTILITY LINE
---	PROPOSED WATER LINE
---	PROPOSED SILT FENCE
---	EXISTING SANITARY MANHOLE
---	EXISTING FIRE HYDRANT
---	EXISTING CLEANOUT
---	EXISTING SPOT ELEVATION
---	PROPOSED SANITARY MANHOLE
---	PROPOSED WATER VALVE
---	PROPOSED THRUST BLOCK
---	PROPOSED FIRE HYDRANT
---	PROPOSED CLEANOUT
---	PROPOSED LIGHTING FIXTURE
---	PROPOSED SPOT ELEVATION
---	PROPOSED DRYWELL
---	PROPOSED CATCH BASIN

Rev	Date	Revision Description
6	10/7/2013	CCSVMC Review Comments
5	9/19/2013	CCSVMC Review Comments
4	7/12/2013	Site Plan Revisions
3	7/15/2013	Site Plan Revisions
2	5/14/2013	Site Plan Revisions
1	3/1/2013	CCSVMC Review Comments

It is a Violation Of The New York Education Law, Article 145 Section 209, For Any Person, Unless He is Acting Under The Direction Of A Licensed Professional Engineer Or Land Surveyor To Alter An Item In Any Way, If An Item Bearing The Seal Of An Engineer Or Land Surveyor Is Altered, The Altering Engineer Or Land Surveyor Shall Affix To The Item His Seal And The Notation "Altered By" Followed By His Signature And The Date. Of Such Alteration, And A Specific Description Of The Alteration.



**PARMENTER TIRE STORAGE AREA**  
VILLAGE OF HORSEHEADS, CHEMUNG COUNTY, N.Y.

**FAGAN ENGINEERS**  
113 East Chemung Place  
Elmira N.Y. 14904  
Phone (607) 734-2165  
Fax (607) 734-2169  
www.FaganEngineers.com

Scale: 1" = 60'  
11x17 Prints are 1/2 Scale  
Date: July 20, 2012  
Design By: KMS, RSN  
Drawn By: RSN  
Checked By: KMS  
Project No.: 2012.052  
Drawing Name: 12052-b.dwg

NOTE: Utility information has been plotted from available sources and their locations and size should be considered approximate only. The contractor is responsible for determining exact utility locations, sizes, and elevations prior to commencing construction. If uncharted or misplaced utilities are encountered, the contractor is required to notify the owner immediately.

New York State law requires excavators to contact the one-call notification system prior to digging to prevent damage to buried facilities.  
IT'S THE LAW!  
Call three days before you dig!  
1-800-962-7862  
Dig Safely New York  
(non-members must be contacted separately)

**FINAL PRINT**  
Copyright © 2012 Fagan Engineers

**GRADING & UTILITY PLAN**  
**C3**